
 **Frank & West**  
Environmental Engineers, Inc.

7226 N. State Route 29  
Springfield, IL 62207

Phone: 217/487-7686  
Fax: 217/407-7687

ROBERT MONDT  
(AS BUILT)  
SITE MAP - DIMENSIONED

2008 C FRANK & WEST ENVIRONMENTAL ENGINEERS, INC.  
THESE PLANS AND SPECIFICATIONS ARE THE PROPERTY OF  
FRANK & WEST ENVIRONMENTAL ENGINEERS, INC., ARE ONLY  
FOR THIS PROJECT AND MAY NOT BE USED, COPIED OR  
DUPLICATED WITHOUT PRIOR WRITTEN CONSENT.

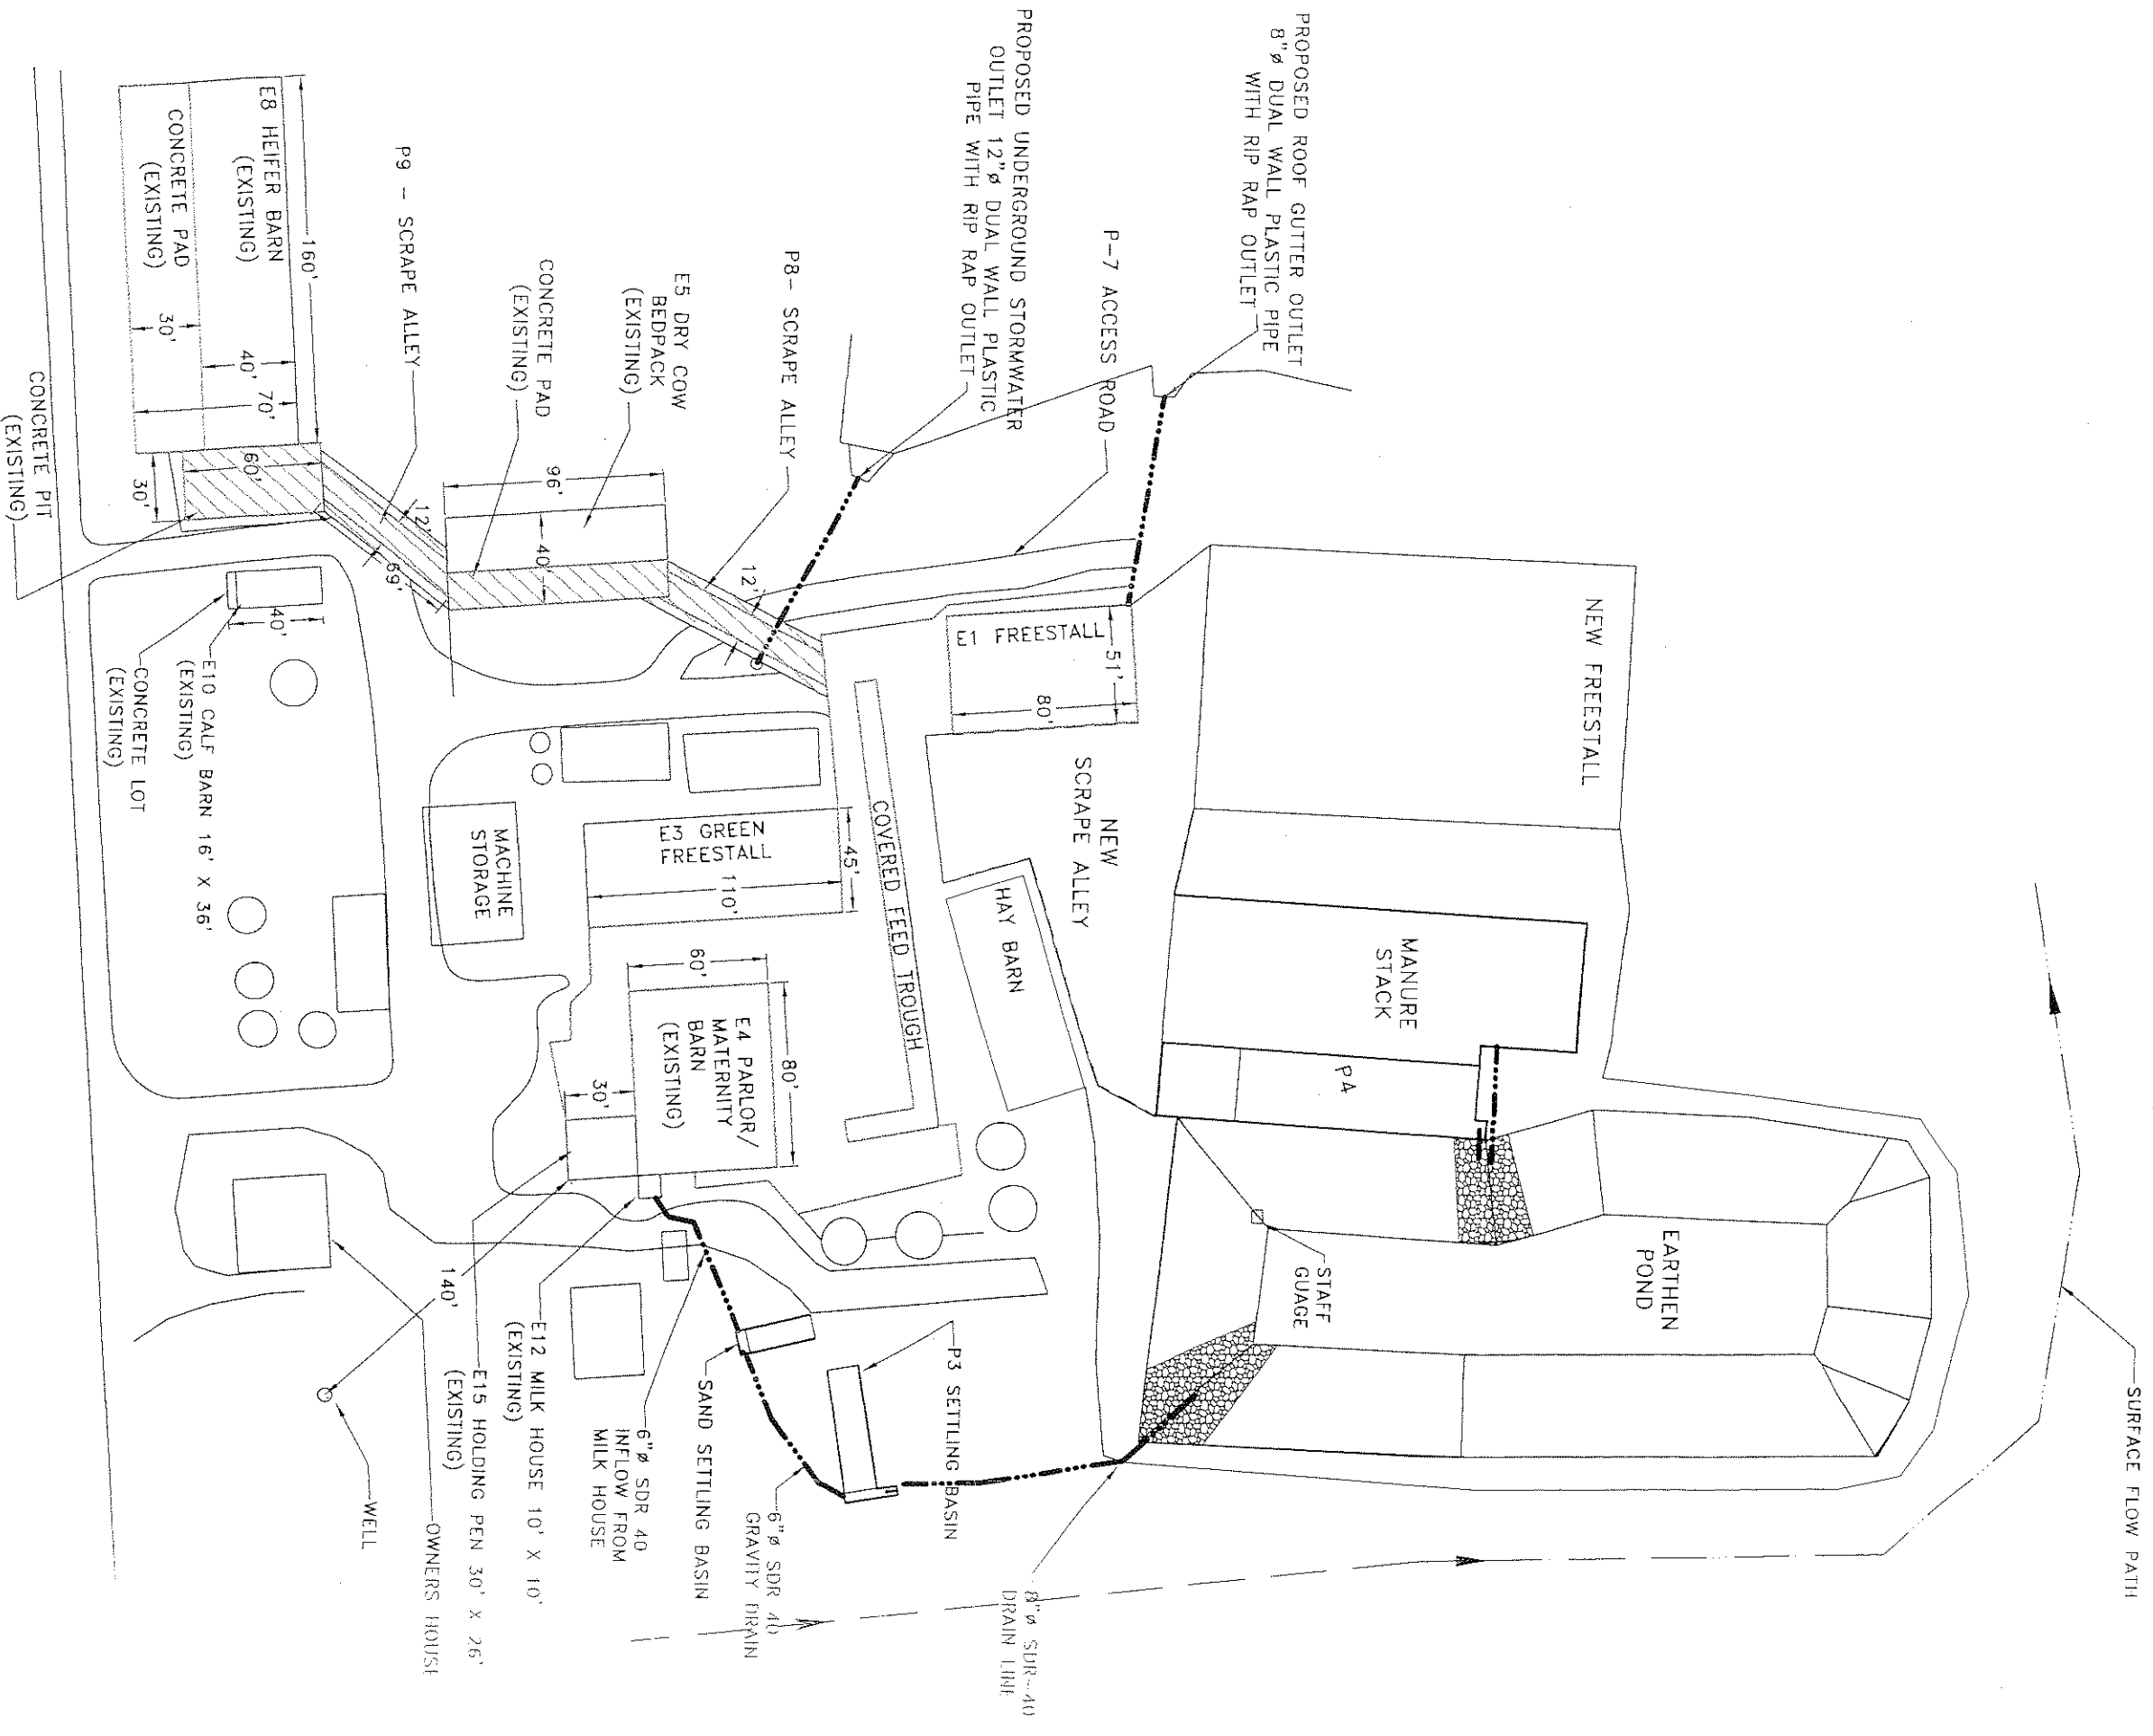

**Frank & West**  
Environmental Engineers, Inc.  
7226 N. State Route 29  
Springfield, IL 62707  
Phone: 217/487-7686  
Fax: 217/487-7687

**ROBERT MONDT**  
SITE MAP - (AS BUILT)  
DRAWN BY: CEO SCALE: AS SHOWN DATE: 03/19/09 REVISED ON: XX/XX/XX DWG. NO 07-17801AS  
2008 © FRANK & WEST ENVIRONMENTAL ENGINEERS, INC.  
THESE PLANS AND SPECIFICATIONS ARE THE PROPERTY OF  
FRANK & WEST ENVIRONMENTAL ENGINEERS, INC., AND (NLI)  
FOR THIS PROJECT AND MAY NOT BE USED, COPIED OR  
DUPLICATED WITHOUT PRIOR WRITTEN CONSENT.